Dart Aerospace Ltd. Thursday, 4/12/2007 8:44:59 AM Date Kim Johnston User: **Process Sheet** : SADDLE FITTING, AFT (OUTBOARD/INBOARD) : CU-DAR001 Dart Helicopters Services **Drawing Name** Customer Job Number : 31718 **Estimate Number** : 10534 : D2574 Part Number :NIA P.O. Number : D2574 REV E : 4/12/2007 **Drawing Number** This Issue : N/A Prsht Rev. Project Number : MACHINED PARTS ; E Drawing Revision First Issue : 30595 : NIA Material Previous Run 12 Um: : 4/30/2007 Qty: Each Due Date Written By Checked & Approved By s Per RevE 06-01-27 Comment : Est Rev: I **Additional Product** Job Number: Description: **Machine Or Operation:** Seq. #: 7075-T7351 8.25X5.0X2.5 1.0 D6101005 Comment: Qty.: 12.0000 Each(s) 1.0000 Each(s)/Unit Total: 7075-T7351 8.25X5.0X2.5 Make from D6101-005 billet for D2574 Ensure that grain is along 5.00" length Batch No: 325057 20 HAAS1 Comment: HAAS CNC VERTICAL MACHINING #1 Program Batch No. B314/8 Double check by: 1-Machine Step No 1 per Folio FA051 and inspect per attached Dimension Sheets 2-Machine Step No 2 per Folio FA051 and inspect per attached Dimension Sheets 3-Machine Step No 3 per Folio FA051 and inspect per attached Dimension Sheets 4-Deburr and remove all machining marks 5-Tumble to remove sharp edges. 12 CONVENTIONAL MILLING MACHINE 3.0 MILLING CONV

INSPECT PARTS AS THEY COME OFF MACHINE

4.0

QC2

Comment: CONVENTIONAL MILLING MACHINE

Machine keyway as per dwg D2573 & D2574

Comment: INSPECT PARTS AS THEY COME OFF MACHINE

12

12

## Dart Aerospace Ltd

W/O:					WORK	ORDER	CHANG	SES				
DATE	STEP			PROCEDU	IRE CHANGE			Ву	Date	Qty	Approval Chief Eng / Prod Mgr	Approval QC Inspector
			V			i.	14-1					
		÷	91) 		•							
		•										

Part No: _	PAR #:	Fault Category:	NCR: Yes No DQA:	Date: <u>07/65/11</u>
			QA: N/C Closed:	Date:

NCR:		WORK ORDER NON-CONFORMANCE (NCR)								
		Description of NC		Corrective Action Section I	3	Verification Section C	Approval Chief Eng	A		
DATE	STEP	Section A	Initial Chief Eng	Action Description Chief Eng	Sign & Date			Approval QC Inspector		
					•					
		8			r					
					6					
		ys T						26.0		
	i									
•				<u>.</u>	2					

NOTE: Date & initial all entries

Thursday, 4/12/2007 8:44:59 AM Date: User: Kim Johnston **Process Sheet** Drawing Name: SADDLE FITTING, AFT (OUTBOARD/INBOARD) Customer: CU-DAR001 Dart Helicopters Services Job Number: 31718 Part Number: D2574 Job Number: Seq. #: Description: Machine Or Operation: SECOND CHECK 5.0 QC8 Comment: SECOND CHECK HAND FINISHING1 HAND FINISHING RESOURCE #1 Comment: HAND FINISHING RESOURCE #1 Acid etch and Alodine as per QSI 005 4.1 POWDER COATING 7.0 M103706 Comment: POWDER COATING Powder Coat White Gloss (Ref: 4.3.5.1) as per QSI 005 4.3 INSPECT POWDER COAT/CHEMICAL CONVERSION 8.0 QC3 Comment: INSPECT PACKAGING 1 9.0 PACKAGING RESOURCE # Comment: PACKAGING RESOURCE #1 Identify and Stock Location: 10.0 QC21 Comment: FINAL INSPECTION/W/O RELEASE U 07.55.12 Job Completion

Dart Aerospace Ltd
--------------------

W/O:		WORK ORDER CHANGES									
DATE	STEP'		PROCEDURE CHANGE		Ву	Date	Qty	Approval Chief Eng / Prod Mgr	Approva QC Inspecto		
		;						۵)			
Part No	·	PAR #	: Fault Category:	NC	R: Yes	No DQ	A:	Date:			
			141		QA:	N/C Close	d:	_ Date: _			

NCR: WORK ORDER NON-CONFORMANCE (NCR)									
		Description of NC		Corrective Action Section B	Verification				
DATE	STEP	Section A	Initial Chief Eng	Action Description Chief Eng	Sign & Date	Section C	Approval Chief Eng	Approval QC Inspecto	
				. 4	-				
		· ·			•				
			9						

NOTE: Date & initial all entries

DART AEROSPACE LTD	Work Order:	31718
Description: Saddle, Aft Inboard	Part Number:	D2574
	•	
Inspection Dwg: D2574 Rev. E		Page 1 of 1

Inspect dimensions highlighted on inspection sheet drawing D2574 Rev. E and record below:

				Recorded Actual Dimensions					
Dim	Min	Max	Go/No Go Gauge	1	2	3	4	Ву	Date
Α	0.438	0.443	*DT8682	6.440	6.446	6.440	0446		
В	1.745	1.755		1.748	1.749	1.745	1747		
С	3.495	3.505		3499	3.500	3500	3.499		
D	1.745	1.755		1.749	1.749	1.749	1.747		
E	7.990	8.010		8.001	8.004	8.002	8.004		
F	0.490	0.510		0496	157.0	0.489	0.498		
Ğ	0.257	0.262	DT8683	5.260	0.260	0.260	0.260		
Н	0.375	0.380	DT8684	6.377	0.377	6.377	0377		
1	0.490	0.510		0.497	0.498	0.498	0478		
J	1.174	1.184		1.175	1.178	1.178	1.176		
K	0.558	0.578		0.564	0.566	0.567	0-566		
L	1.174	1.184		1.179	1.178	1.178	1.176		
М	1.365	1.375		1.369	1.370	1.369	1.369		
N	2.495	2.505		2.490	2.498	2.497	2499		
0	4.119	4.129		4.127	4.122	4.173	4.121		
Р	0.115	0.135		0.127	6.127	0.127	D. 126		
Q	0.115	0.135		6.135	0.135	0.131	0/35		
R	0.240	0.260	-	0.252	6.252	0.252	D.252		
S	0.115	0.135		6-125	0.125	0.125	0126		
T	0.178	0.198		0188	0188	0 188	0:188		
U	3.210	3.250		3.236	3.230	3,230	3.230		
V	0.230	0.250		0.777	0.239	0.238	0.238		
W	0.115	0.135		0.134	0.131	B-127	0-131		
Х	0.307	0.312		6311	0.311	0.310	0-310		141
Υ	0.760	0.765		0.765	0.765	6.765	0.765		
Z	0.352	0.372		0.366	0.362	0.362	0.362		
AA	0.470	0.530		6.500	0.500	6.290	کھکیں		
AB	0.615	0.635		6-626	0.626	0 62%	0627		
AC	0.053	0.073		0.063	0.063	0.063	0.663		
AD	0.240	0.260		z 25/	6.249	0.249	0.249		
ΑE	1.500	1.520		1.510	1.511	1.511	1.5/0		
AF	0.115	0.135		6.135	6.135	6.135	6.135		
AG	0.240	0.280		6.760	6.260	0.260	0.266		
AH	0.240	0.260		0.248	0.249	0.250	0248		
Al	2.000	2.020		2.000	2.000	2.000	2.000		
AJ	0.023	0.043		0033	6.033	6.033	6033		
	Acc	ept/Reje	ct						

Measured by: しの	Audited by SA
Date: 0705 05	Date: 07.05.06

Rev	Date	Change	Revised by	Approved
Α		New Issue	RF	
В	02.09.27	Re-format; Added Rev. D	KJ	
С	.02.10.11	Re-format; Added DT8682, DT8683, DT8684	KJ	
D	05.05.05	Added dimension Al	KJ/RF	1
Ē	05.12.05	Added dimension AJ	KJ/JLM 🚓	adl

DART AEROSPACE LTD	Work Order:	31718
Description: Saddle, Aft Inboard	Part Number:	D2574
Inspection Dwg: D2574 Rev. E	4	Page 1 of 1

Inspect dimensions highlighted on inspection sheet drawing D2574 Rev. E and record below:

				Recorded Actual Dimensions					
Dim	Min	Max	Go/No Go Gauge	1	2	3	4	Ву	Date
Α	0.438	0.443	<del>DT868</del> 2	6.440	0.440	0.440	0.440		
В	1.745	1.755		1.749	1,750	1.748	1,748		P
С	3.495	3.505		3.498	3500	3.497	3.499		
D	1.745	1.755		1.749	170	1.748	1.748		
E	7.990	8.010	•	8062	80.004	8.004	8,003		
F	0.490	0.510		0.500	0.494	0.498	o. 796		
G	0.257	0.262	<del>DT868</del> 3	0.266	0.260	0.260	0260		
Н	0.375	0.380	DT8684	0.377	0.377	0.371	0 377		
ı	0.490	0.510		0.498	0.496	0.499	0.498		
J	1.174	1.184		1.176	1178	1.177	1.176		
K	0.558	0.578		0.566	0-565	0568	0.565		
L	1.174	1.184		1.176	1.170	1.177	1.176		
M	1.365	1.375		1.369	1.367	1369	1.368		
N	2.495	2.505		2.498	2.497	2.497	2.498		
0	4.119	4.129		21.123	4.177	4,123	4.123		
Р	0.115	0.135		6-126	0.127	0.128	6.127		
Q	0.115	0.135		0.135	0.135	6.135	6.135		
R	0.240	0.260		0.252	0.252	0.252	0.252		
S	0.115	0.135		0.123	0.122	0.123	6.126		
T	0.178	0.198		0.188	0.188	0.188	0.186		
U	3.210	3.250		3.230	3.230	3.230	3.230		
V	0.230	0.250		0.239	0.739	0.239			
W	0.115	0.135	***************************************	6.132	0.239	0.130	0.154		
X	0.307	0.312		0.311	0.311	0.311	4.311		
Υ	0.760	0.765		0.765	0.765	0.765	0.765		
Z	0.352	0.372		0.362	0.362	0.365	0.365		
AA	0.470	0.530		6.500	0.500	0.500	0.500		
AB	0.615	0.635		0.626	0.625	0.626	0.627		
AC	0.053	0.073		0.063	0.063	0.063	0063		
AD	0.240	0.260		6.248	0249	0.249	0.248		
AE	1.500	1.520		1.510	1.510	1.510	1.510		
AF	0.115	0.135		0.135	0.135	0.135	0.135		
AG	0.240	0.280		6.260	0.260	0.260	0.260		
AH	0.240	0.260		0.250	0251	0.249	0.752		
ΑI	2.000	2.020		2.000	2.000	2.000	2.800		
AJ	0.023	0.043		0.033	8.033	0.033	ه 33		
	Acc	ept/Reje	ct						

Measured by:	Audited by SD
Date: 07/05/06	Date: 67,06.07

Rev	Date	Change	Revised by Approve
Α		New Issue	RF
В	02.09.27	Re-format; Added Rev. D	KJ
С	02.10.11	Re-format; Added DT8682, DT8683, DT8684	KJ
D	05.05.05	Added dimension Al	KJ/RF
E	05.12.05	Added dimension AJ	KJ/JLM A

	the of said as seems the real		*	•		
			ŀ			
						i.
1						
						1
						1
		e þ				
				•		
· · · · · · · · · · · · · · · · · · ·					r(w)	
						:
					,	·
						1
	<b>4</b>					
		1				
	<i>:</i>				(*)	
	· · · · · · · · · · · · · · · · · · ·		•			
L				4		
					•	
<b>~</b>						
	*					
		,			×	
No. of the last of						
			λ.			3.4.
	(4)			1		هور د مشهر
**************************************						
					•	•
	V					

1


DART AEROSPACE LTD	Work Order:	31718
Description: Saddle, Aft Inboard	Part Number:	D2574
Inspection Dwg: D2574 Rev. E		Page 1 of 1

Inspect dimensions highlighted on inspection sheet drawing D2574 Rev. E and record below:

				Recorded Actual Dimensions					
Dim	Min	Max	Go/No Go Gauge	1	2	3	4	Ву	Date
Α	0.438	0.443	DT8682	6:440	0.440	0.440	0.440		
В	1.745	1.755		1.748	1.749	1.750	1:750		
С	3.495	3.505		3.5∞	3.500	3.500			
D	1.745	1.755		1.748.	1.749	1.749	1.750		
Е	7.990	8.010		8.003	8.004	8.002	8.002		
F	0.490	0.510		0.801	0.497	cos.	.50D		
G	0.257	0.262	D <del>T8683</del>	0.260	0.260	0.260	0.260		
Н	0.375	0.380	D <del>T86</del> 84	0.377	0.377		0.377		
1	0.490	0.510		6497	0.498	.soo	.500		
J	1.174	1.184		1.174	1.176	1.179	1.179		
K	0.558	0.578		0.563	0.567	562	-562	Ça-	
L	1.174	1.184		1.174	1.176	1.177	1,177		·
М	1.365	1.375		1.366	1.368	1.368	1.368		
N	2.495	2.505		2.497	2.496	2.499	2.499	-	
0	4.119	4.129		4.122	4.170	4.122	4122		
Р	0.115	0.135		6.127	0.126	.125	.125		
Q	0.115	0.135		6.135	6:136	0.135	0.135		
R	0.240	0.260		0.252	0.523	*525 J	.25Z		
S	0.115	0.135		0.126	0-129	.125	.125		
T	0.178	0.198		6.188	0.188	6.188	0:188		
U	3.210	3.250		3.230	3.230	3.230	3.230		
V	0.230	0.250		0.240	o 239	OPC.	046.		
W	0.115	0.135		6:132	6-137	.132	-133		*
Χ	0.307	0.312		0.311	0.311	.312	,312		
Υ	0.760	0.765		0.765	0.765	0-765	0.765		
Z	0.352	0.372		0.367	0.365	.367	.367		
AA	0.470	0.530		0.500	0:500	0500	6.500		
AB	0.615	0.635		0.676	0.627	.627	<i>a</i> ca).		
AC	0.053	0.073		0.663	0.068	0.063	0.063		
AD	0.240	0.260		0.548	0.248	·520	.2SO		
AE	1.500	1.520		1.510	1.510	1.509	1,509		
AF	0.115	0.135		0.135	0.135	6'135	0.135		· · · · · · · · · · · · · · · · · · ·
AG	0.240	0.280		0.260	0.590	0.260	0.266		
АН	0.240	0.260		0.251	6.249	・シェク	.520		
Al	2.000	2.020		2.000	0.000	0.000	8.000		
AJ	0.023	0.043		0.033	0033	0.033	<b>%33</b>		
	Acc	ept/Reje	ct						

	<del></del>		
Measured by:	-0/MS	Audited by	<i>J.</i> L.
Date:	07/05/08	Date:	07/05/08

Rev	Date	Change	Revised by App	roved
Α		New Issue	RF	
В	02.09.27	Re-format; Added Rev. D	KJ	
С	02.10.11	Re-format; Added DT8682, DT8683, DT8684	KJ	
D	05.05.05	Added dimension Al	KJ/RF	- 1
E	05.12.05	Added dimension AJ	KJ/JLM 🙏 🔾	7//

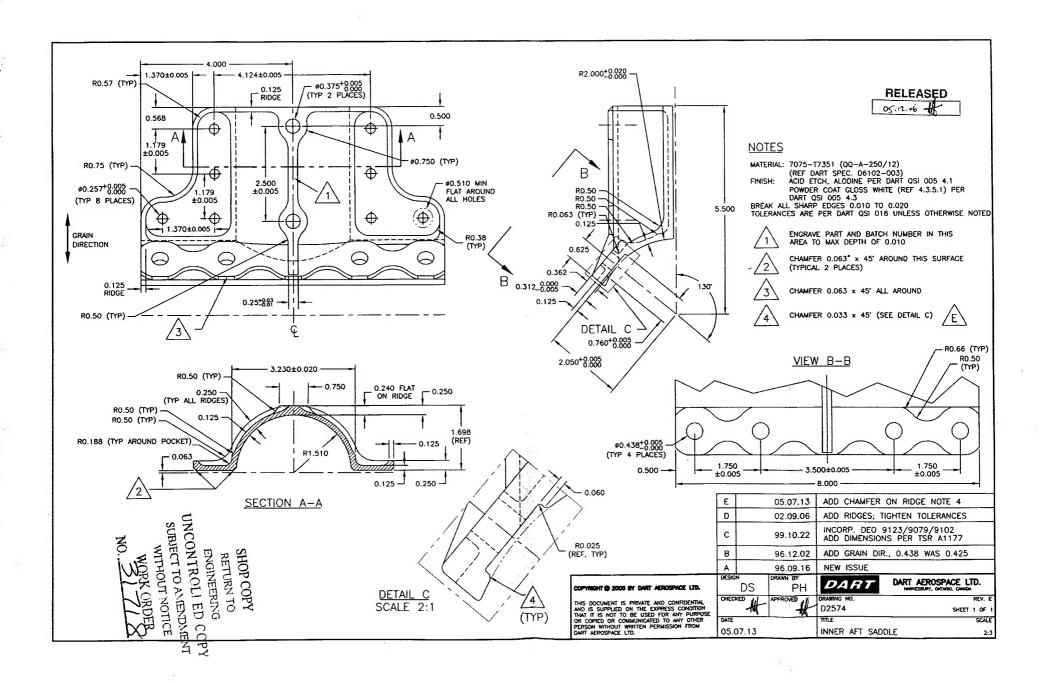

						7
		19.7			÷ .	
		4 3 4				
		e Signe				
					٠.	
			÷			
*		L <sup>2</sup>			•	
		. 30				
					÷	*5
		e de la companya de l				
					-	
				* N	^	
		d .	(3) **			
					-	
						*6
	•				·	
		•				
•		4		•		
				4		Berry .
<b>L</b>		2 - A13: Cr. 39 - 4 2				